


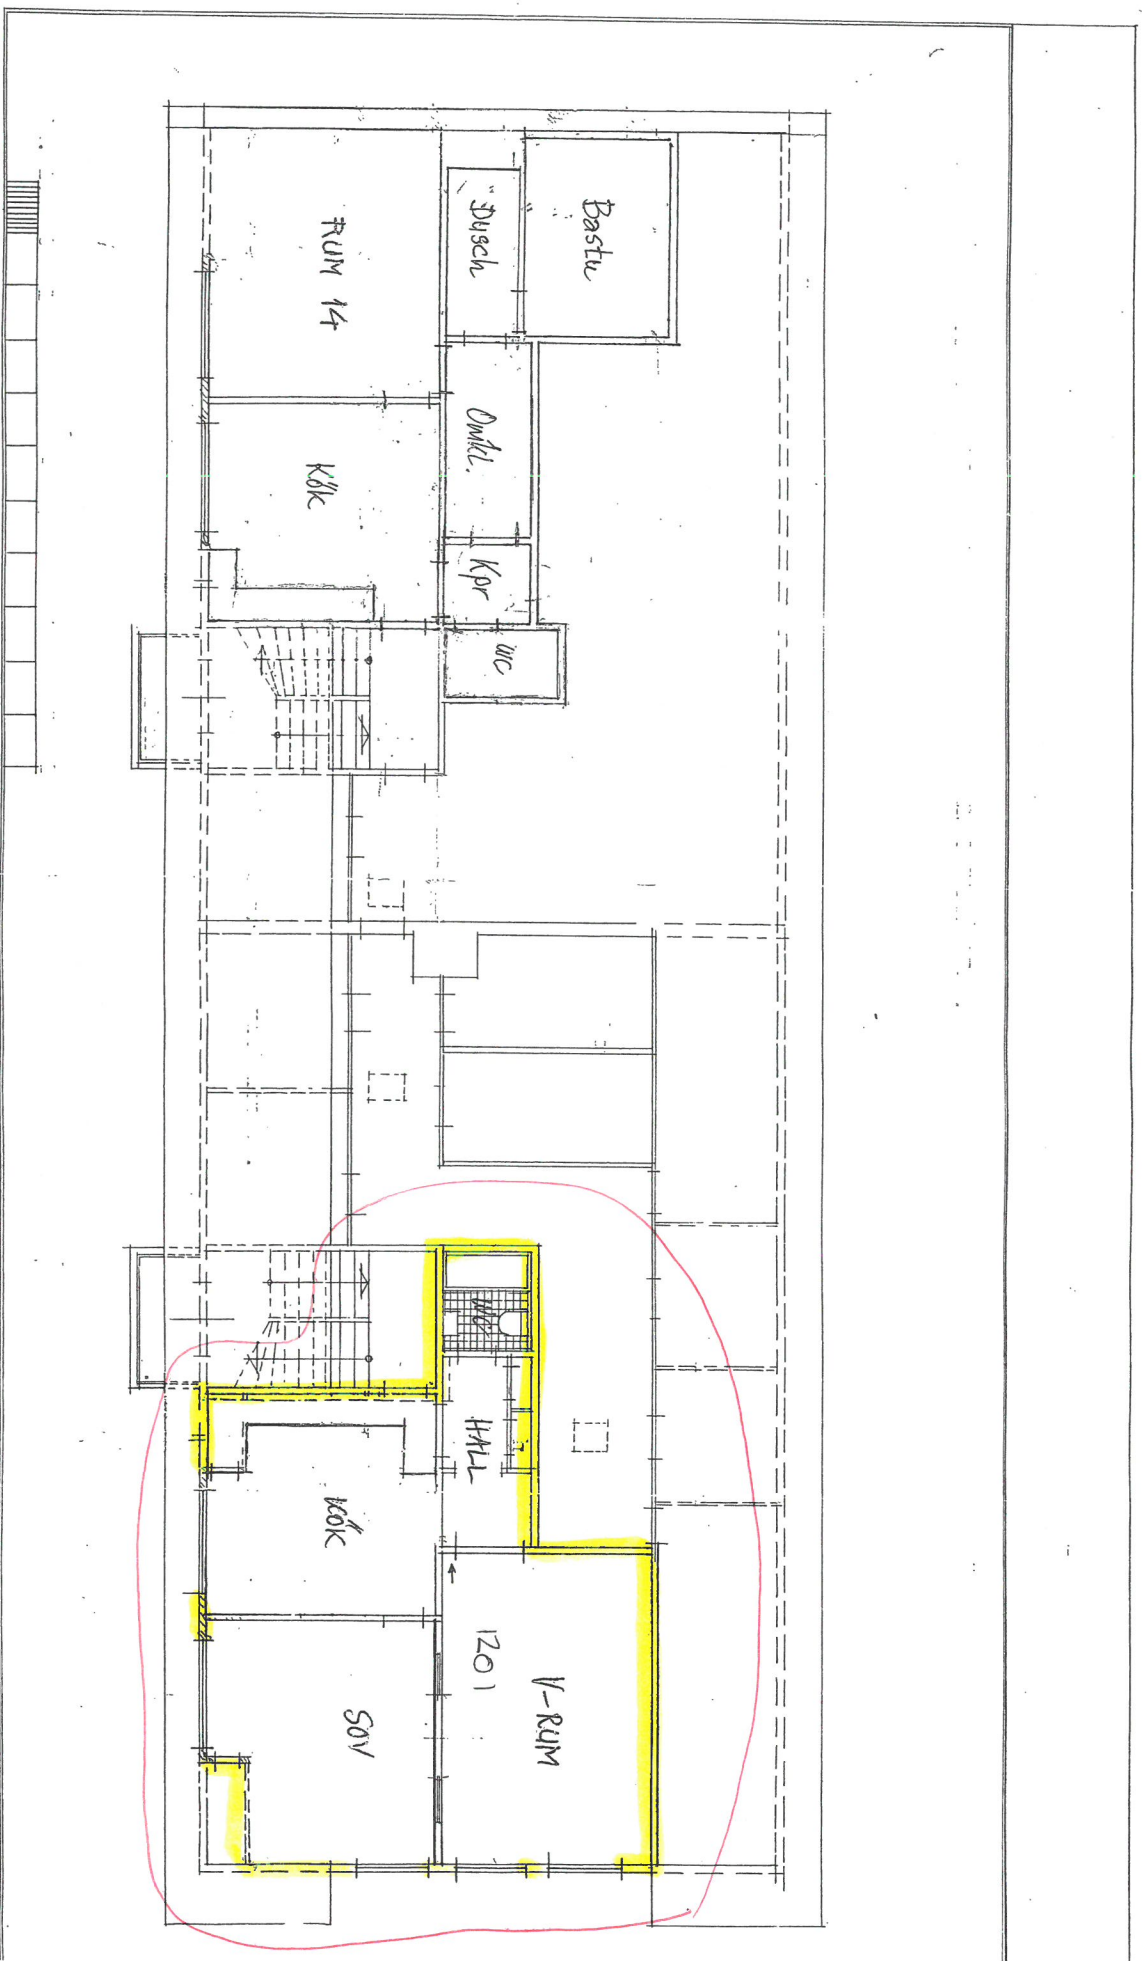

Kv. Valen 7. Luleå.
Relationsritning. Vår 2.
2002-06-03. 1:100.